


DISTANCES BY HORIZONTAL MEASUREMENT
BEARINGS ASSUMED FROM TURNED ANGLES
SUB SURFACE FEATURES AND UTILITIES ARE NOT SHOWN UNLESS NOTED
REAR POINTS FOUND 20' FROM CURB UNLESS OTHERWISE NOTED
APPROXIMATE ANGLE OF CLOSURE (FIELD) 1 FT. IN 10,000 FT.
TOTAL STATION SURVEY/ADJUSTED BY THE LEAST SQUARES METHOD
PLAT PREPARED JUNE 29, 2005
COPYRIGHT 2005 ROBERT W. HURLEY, III
THIS SURVEY IS CONDUCTED FOR THE USE OF THE PERSON NAMED IN
THIS INSTRUMENT AND NO OTHER PERSONS OR OTHERS IS NOT
AUTHORIZED AND IS AT THEIR OWN RISK.
ALL ELEVATIONS OF RECORD MAY NOT BE SHOWN
UNLESS SHOWN & UTILITY LOCATION BASED ON SURFACE PAINT MARKS
& RECORDS AND MAY NOT BE COMPLETE
CALL 1-800-222-7411 FOR VERIFICATION & LOCATION

- LEGEND (REPAIR UNLESS NOTED)
- REAR PNT FOUND (REPAIR UNLESS NOTED)
 - REAR/YELLOW CURB SET
 - FENCE
 - FENCE BOOK
 - STORM SEWER
 - NATURAL GAS LINE
 - WATER LINE
 - OVERHEAD TELEPHONE LINE
 - UNDERGROUND TELEPHONE LINE
 - UTILITY POLE
 - UNDERGROUND POWER LINE
 - GATE/CURB INLET
 - VALVE/METER BOX
 - LIGHT POLE
 - IRRIGATION CONTROL BOX
 - MANTLE

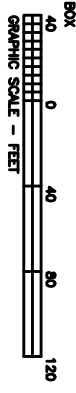

COMPILED 1987 CONTOUR LINES
PG 24/130

REVISIONS
 AUGUST 12, 2005 (1987 BLDG.)
 JULY 29, 2005 (MISC. DETAILS & OFFSITE DETAILS)
 JULY 14, 2005 (MISC. DETAILS)

AS BUILT SURVEY
 FOR
SUNNAT RETAIL PARK
 LAND LOTS 118 & 149 FOURTH LAND DISTRICT
 MOUNTAIN VIEW COUNTY, GEORGIA
 Scale 1"=40'
 ROBERT W. HURLEY, III
 LICENSED PROFESSIONAL SURVEYOR NO. 2194
 GEORGIA SURVEYING BOARD
 13-2941